
"BLAKES SEVEN" ~ SPACE FALL ~ DESIGNER ROGER MURRAY-LEACH ZERO ~~31~~ 28 OCT VTR 1 & 2 NOV PROJ No 2247/1522 SHEET 1 OF 4

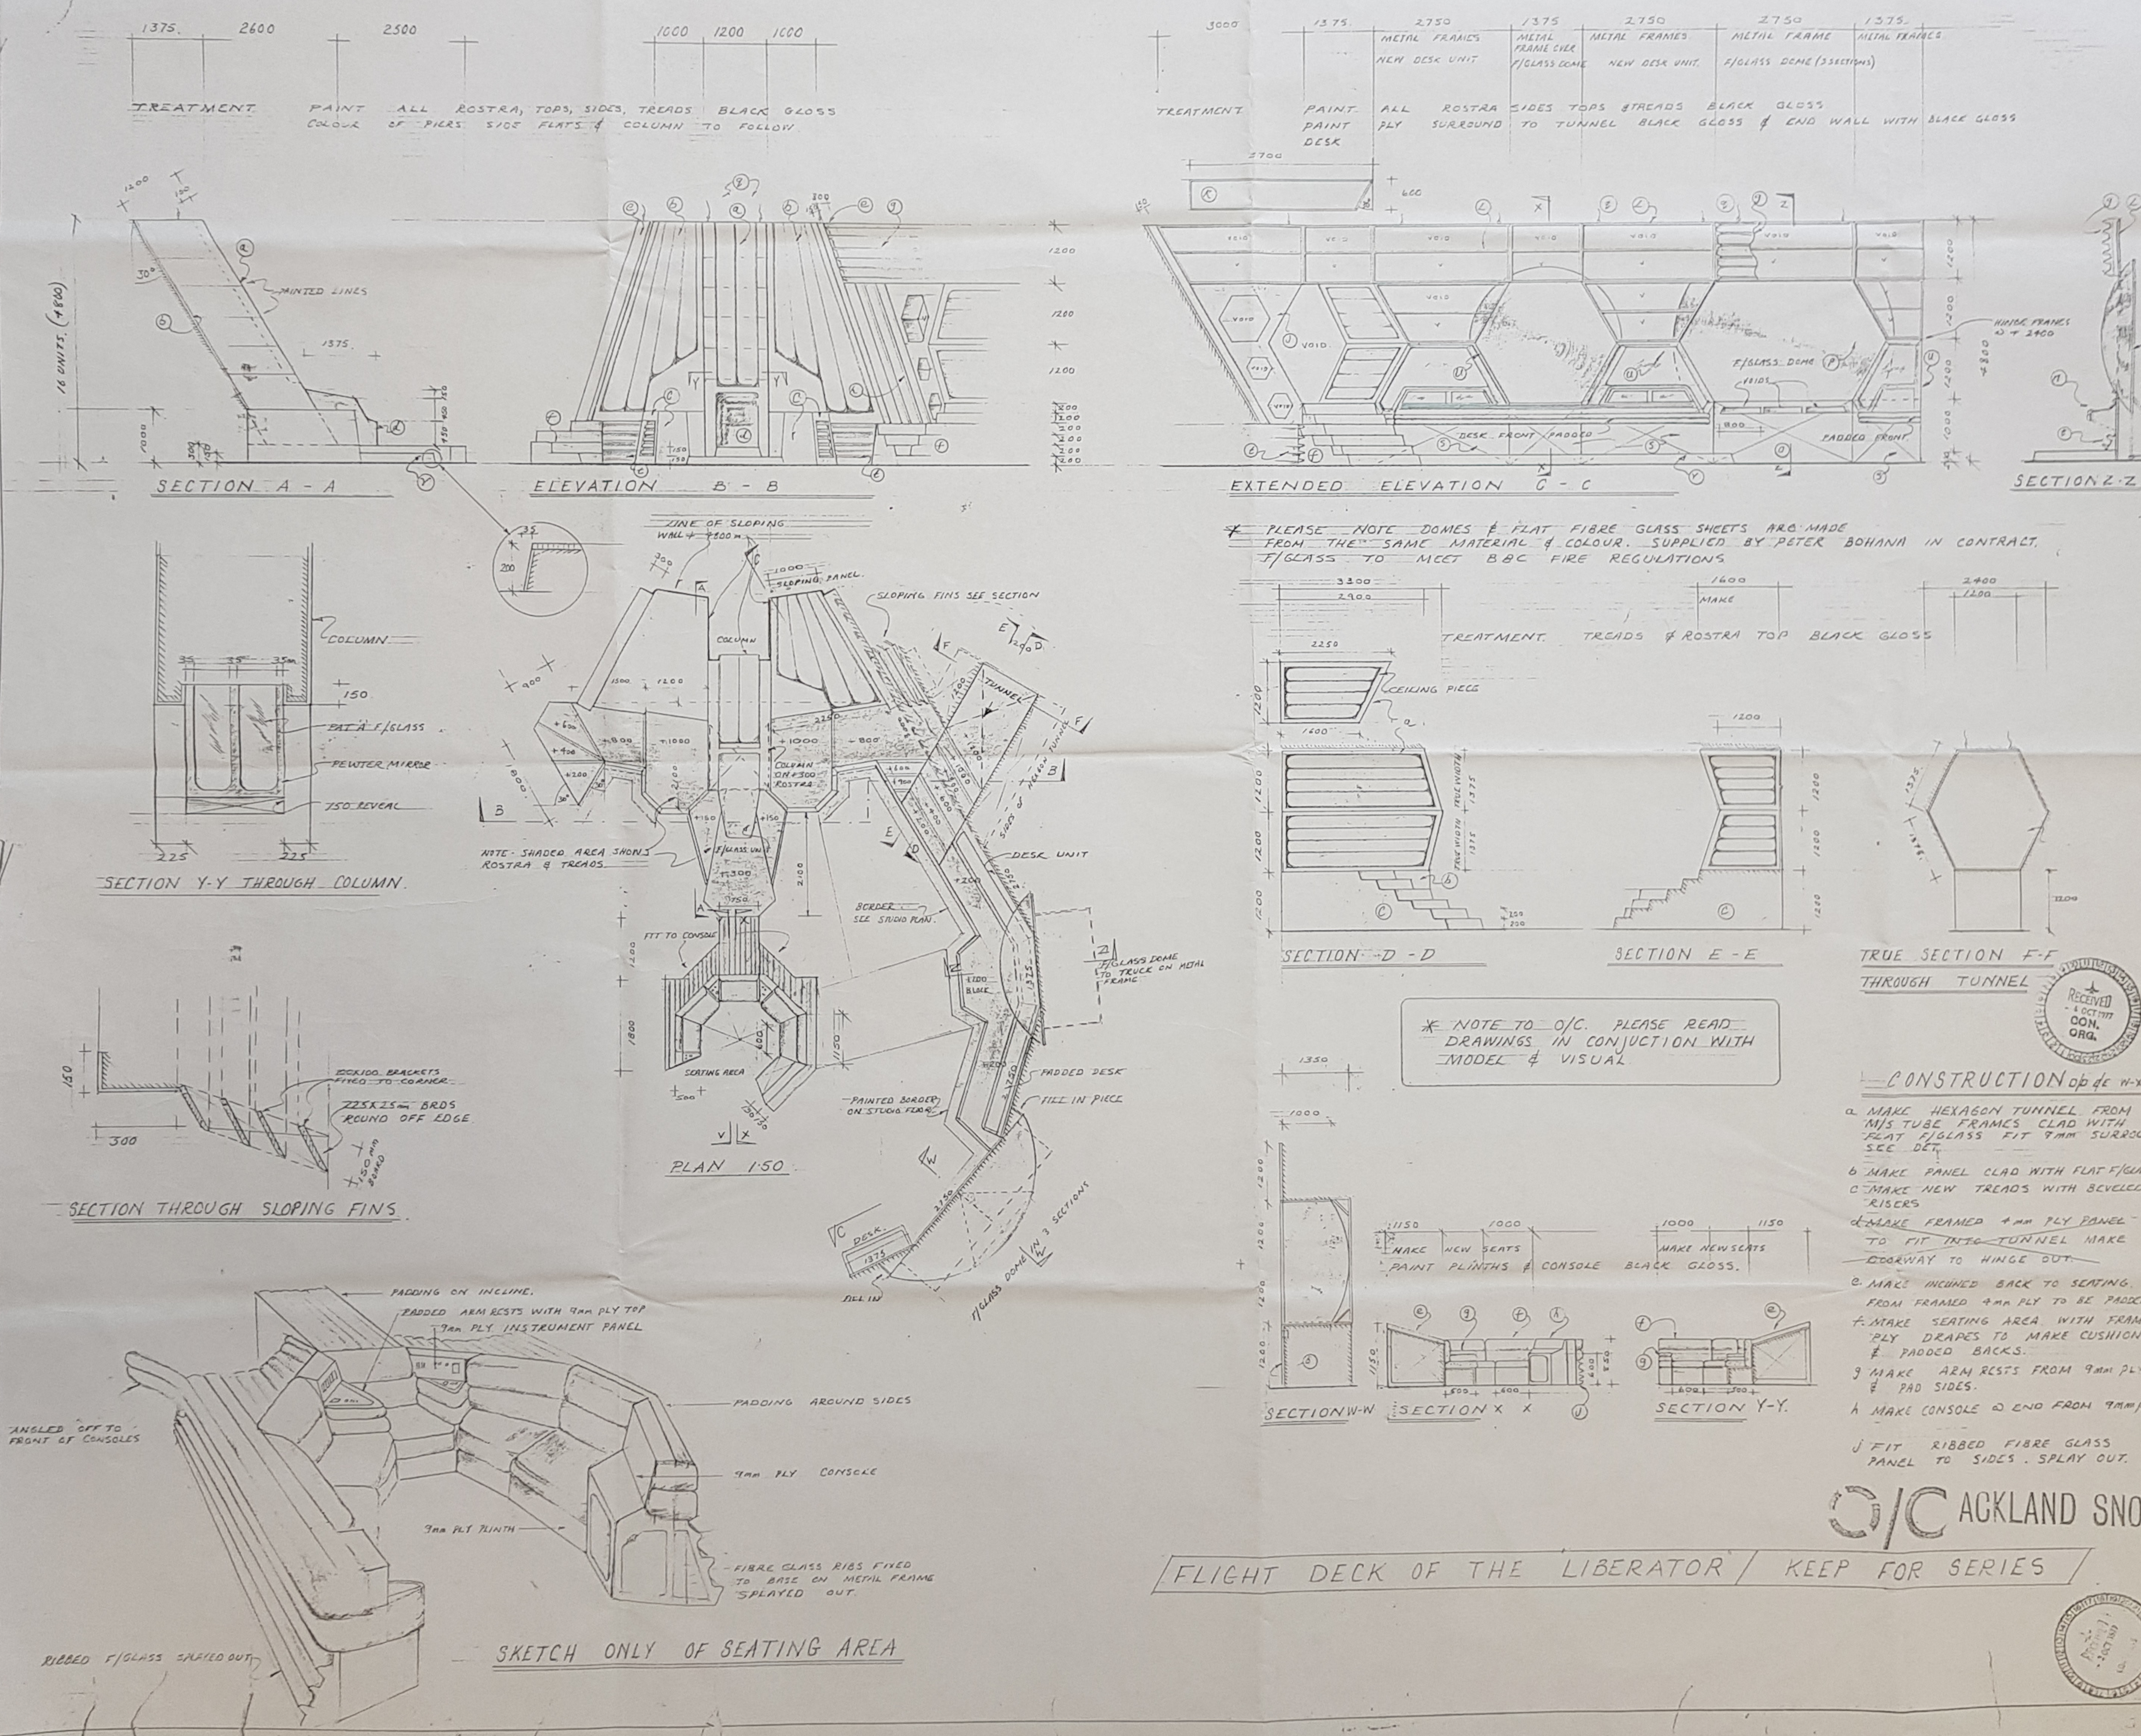

* NOTE TO O/C. PLEASE READ DRAWINGS IN CONJUCTION WITH MODEL & VISUAL

CONSTRUCTION op de W-X-Y

a MAKE HEXAGON TUNNEL FROM M/S TUBE FRAMES CLAD WITH FLAT F/GLASS FIT 9mm SURROUND SEE DET.
b MAKE PANEL CLAD WITH FLAT F/GLASS
c MAKE NEW TREADS WITH BEVELED RISERS
~~d MAKE FRAMED 4mm PLY PANEL TO FIT INTO TUNNEL MAKE DOORWAY TO HINGE OUT.~~
e. MAKE INCLINED BACK TO SEATING. FROM FRAMED 4mm PLY TO BE PADDED
f. MAKE SEATING AREA WITH FRAMED PLY DRAPES TO MAKE CUSHIONS & PADDED BACKS.
g MAKE ARM RESTS FROM 9mm PLY & PAD SIDES.
h MAKE CONSOLE @ END FROM 9mm PLY.
j FIT RIBBED FIBRE GLASS PANEL TO SIDES. SPLAY OUT.

O/C ACKLAND SNOW

FLIGHT DECK OF THE LIBERATOR / KEEP FOR SERIES

CONST[...]ION

ALL NEW [...]S
a MAKE SLO[...] COLUMN FROM FRAMED 4[...] 1200 X 1200 FIT RECESS TO FRONT FIT MILKY FIBRE GLASS PANEL. SEE DET.
b MAKE 2 OFF HANDED PANELS TO SLOPE AT 30° MAKE FROM 4mm PLY WITH MILKY FIBRE GLASS FIXED TO BACK. SEE DET.
c MAKE ROSTRA AS SHOWN WITH BEVELED SIDES FIT LOUVRED GRILL. (DES TO SUPPLY)
d MAKE UNIT WITH TIMBER AND COVER WITH FIBRE GLASS ROUND OFF ALL CORNERS. SEE MODEL
e SIDE PIERS FROM FRAMED 4mm PLY WIDTH 300mm, REVEAL 150. BOARD.
f. MAKE TREADS WITH BEVELED RISER TO SIZES SHOWN.
g MOULDED FIBRE GLASS TO HOOK ON TO 25mm SQ M/S TUBE
h SLOPING BRDS AS FINS (225 x 25mm) SEE DET
j MAKE SECTION OF WALL FROM M/S TUBE WITH RANDOM HEXAGON SHAPED VOID 300mm DEEP. FACE WITH FLAT F/GLASS HEXAGON VOIDS & 300mm REVEALS.
k 600mm WIDE SOFFIT WITH M/S TUBE FRAME FACE WITH 4mm PLY. FIT HANGING IRONS.
l M/S TUBE FRAMES TO BE HINGED @ + 2400 FOR EASE OF TRANSPORT
m. MAKE M/S TUBE FRAME FOR F/GLASS DOME TO TRUCK (TO PUSH INTO VOID)
n. MAKE NEW DESK & SCREENS SEE DET.
o. MAKE + 1200 ROSTRA FOR SECTION OF F/GLASS DOME CLAD FRONT WITH FLAT FIBRE GLASS CUT VOIDS 100mm WIDE.
p F/GLASS DOME IN 3 SECTIONS MAKE M/STEEL SUPPORT FRAME BEHIND
q FIT HANGING IRONS
r MAKE + 200 BLOCK WITH BEVELED FRONT
s MAKE METAL FRAMES & CLAD WITH FLAT F/GLASS.
t APPLY RIBBED FIBRE GLASS
u. MAKE M/S FRAME. FIT RIBS TO EDGE SEE DET.

ARTISTS O/C

WORK OVER SET TO PHOTO REF & DES INSTRUCTIONS.

METAL WORKERS

MAKE M/S TUBE FRAMES TO HOOK F/GLASS PANELS ON. ALL TO BOLT TOGETHER.

SPECIAL MATERIALS

* PEWTER MIRROR 2'0" WIDE @ 45p PER SQ FOOT. SELF/ADH
* PLASTISTRIP DCH 14/T @ 5/P METRE.
* PAT A MILKY WHITE F/GLASS FROM A. MARCHANT 70p SQ FT. MAX WIDTH 5'4".
* RIBBED & FLAT FIBRE GLASS SHEETS IN CONTRACT FROM FROM PETER BOHANA - TO BBC FIRE REG
* FLEXNIT NADI BEIGE £1.64 PER METRE. J.H. PORTER.

DRAPES ~~BBC~~ A/SNOW

MAKE PADDED CUSHIONS SEATS AND DESK PADDING.

FLOOR PAINTING

700 SQ UNITS DET FOLLOW
200mm BORDER

RECEIVED 29 SEP 1977 DESIGN MANAGER
RECEIVED 4 OCT 1977 CON. ORG.

BBC tv DESIGN DEPARTMENT

SHEET NO 1	DATE DRAWN	DES. CHECK	C m
NO OF SHEETS 4	SCALE 1:50		
DES DISTRIBUTION: DESIGNER, DESIGN ASST., DESIGNER SALING, ELECTRICIANS, MODEL MAKERS, METAL WORKERS, PROCESS PROJECTION, SCENIC ARTISTS, VISUAL EFFECTS, DRAPES, GRAPHICS, ASST. PLASTICS, ASST. PRODUCTIONS, ASST. ALLOCATIONS	GEN DISTRIBUTION: ALLOCATIONS (Tvm), DIRECTOR, P.M'S OFFICE, A.S.T.M.(TM), MANAGER STUDIO OPS, DAY MANAGER, NIGHT MANAGER, SCENERY BOOKING CLERK, SUPERVISOR SALING, SCENERY STORES BRANDS, ESTIMATOR, CONST ORGANISER, ASST. WORKSHOP MAN., SUP'G SUPPLY MAN, O/CONTRACTOR, DESIGN MANAGER, CONTRACTS	Contracts Manager [signature] DATE 2-Oct; DRAWING MANAGER [signature] DATE 3.10.77; DWG MAN CHECKED; BLUES ISSUED 30/9/77	

DIRECTOR PENNANT ROBERTS Room 5076
DESIGNER ROGER MURRAY-LEACH Ext 2500
DRAWN BY LES McCALLUM Ext 2571
ZERO 28 OCT.
V.T.R. 1/2 NOV
FILM ZERO
FILM DATE
studio TC 3
PRODUCTION BLAKES SEVEN SPACE FALL
PROJECT NO 2247/1522